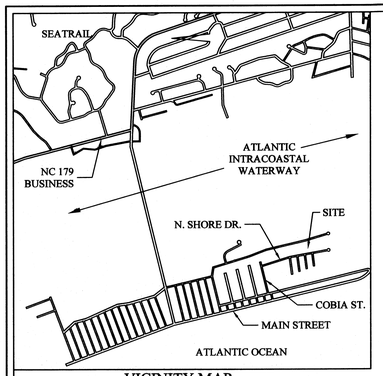

VICINITY MAP
NO SCALE

GLOBAL POSITIONING SYSTEMS CERTIFICATE

I, CHRISTOPHER D. STANLEY, CERTIFY THAT THE GRID TIE TO THE BOUNDARY CORNER SHOWN WAS PERFORMED UNDER MY SUPERVISION FROM AN ACTUAL GPS SURVEY MADE UNDER MY SUPERVISION AND THE FOLLOWING INFORMATION WAS USED TO PERFORM THIS SURVEY:

CLASS OF SURVEY:	A
POSITIONAL ACCURACY:	0.022 METERS
TYPE OF GPS FIELD PROCEDURE:	RTN
DATES OF SURVEY:	11/15/2011 - 11/17/2011
DATUM/EPOCH:	NAD 83
PUBLISHED /FIXED CONTROL.:	RTN
GEIOD MODEL:	09
COMBINED GRID FACTOR:	1.000139129
UNITS:	US FEET

I, CHRISTOPHER D. STANLEY, P.L.S., CERTIFY THAT THIS PLAT OF SURVEY IS A TRUE AND ACCURATE REPRESENTATION OF LAND SURVEYED AND PLATTED UNDER MY DIRECT SUPERVISION AND IS IN ACCORDANCE WITH THE STANDARDS AND PRACTICE FOR LAND SURVEYING IN NORTH CAROLINA. WITNESS MY ORIGINAL SIGNATURE, REGISTRATION NUMBER AND SEAL THIS 13TH DAY OF JUNE, 2012.

CHRISTOPHER D. STANLEY, P.L.S. NC L-3387

NORTH CAROLINA PROFESSIONAL SEAL L-3387 LAND SURVEYOR CHRISTOPHER D. STANLEY

NC GRID NORTH
NAD 83 (NSRS 2007)

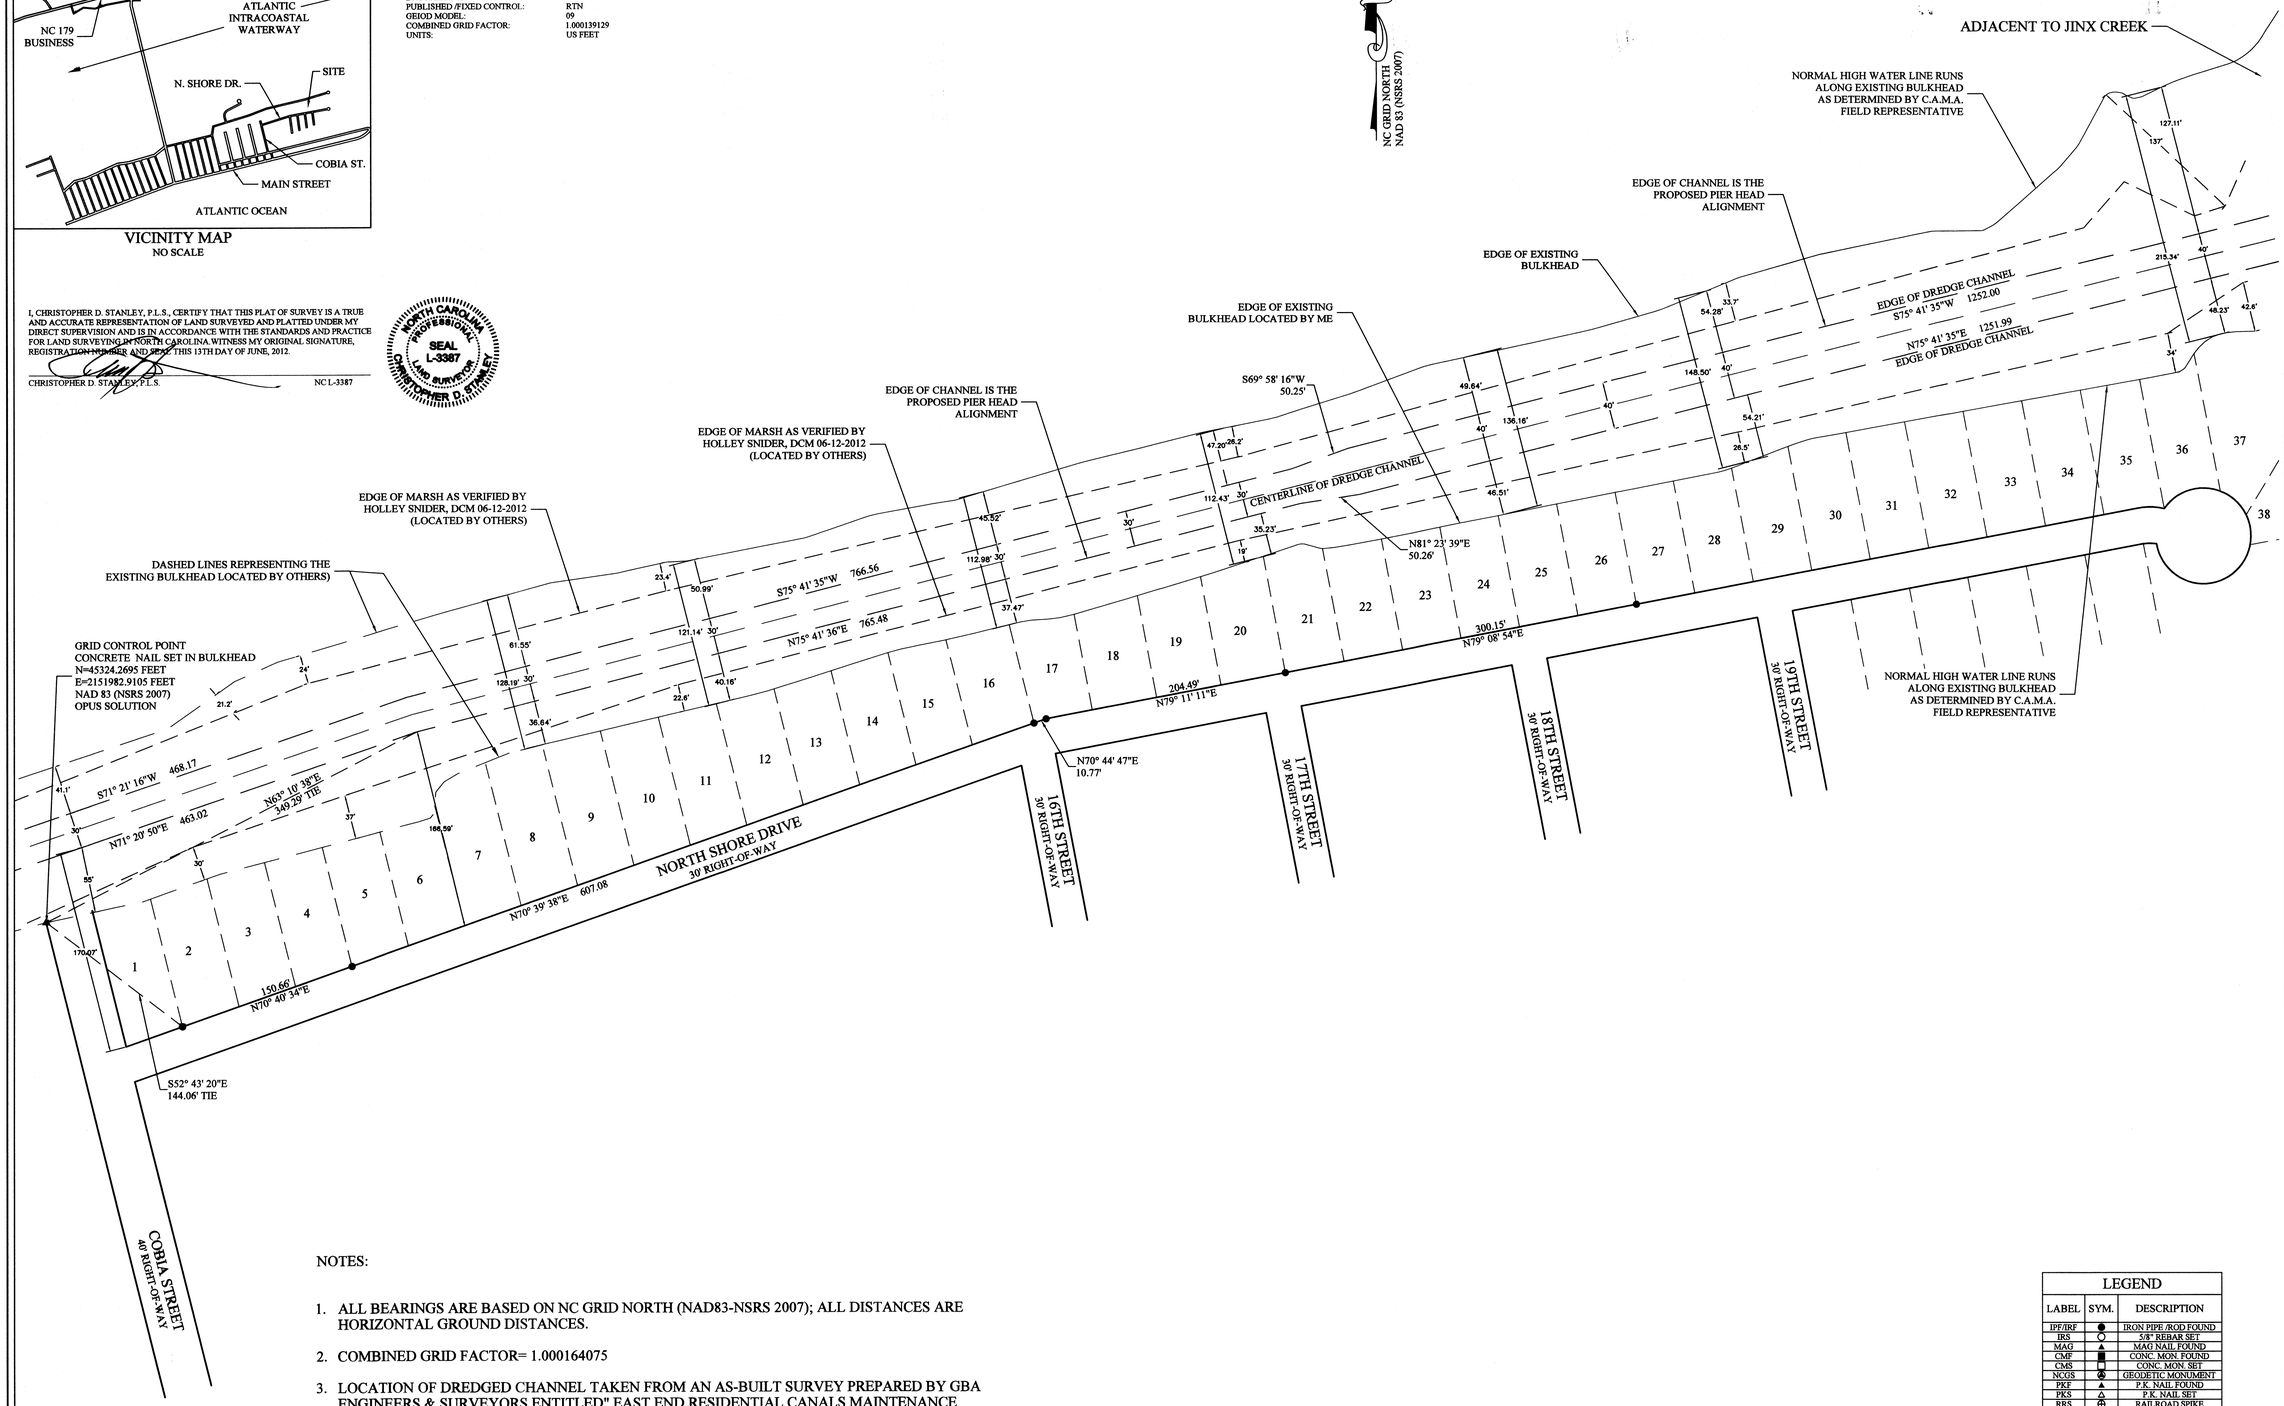

NOTES:

1. ALL BEARINGS ARE BASED ON NC GRID NORTH (NAD83-NSRS 2007); ALL DISTANCES ARE HORIZONTAL GROUND DISTANCES.
2. COMBINED GRID FACTOR= 1.000164075
3. LOCATION OF DREDGED CHANNEL TAKEN FROM AN AS-BUILT SURVEY PREPARED BY GBA ENGINEERS & SURVEYORS ENTITLED" EAST END RESIDENTIAL CANALS MAINTENANCE DREDGING FOR TOWN OF SUNSET BEACH, DATED MAY 13, 2003.
4. THIS PLAT IS NOT FOR RECORDING.

LEGEND		
LABEL	SYM.	DESCRIPTION
IPF/IRF	●	IRON PIPE /ROD FOUND
IRS	○	5/8" REBAR SET
MAG	▲	MAG NAIL FOUND
CMF	■	CONC. MON. FOUND
CMS	□	CONC. MON. SET
NCGS	⊗	GEODETIC MONUMENT
PKF	▲	P.K. NAIL FOUND
PKS	△	P.K. NAIL SET
RRS	⊕	RAILROAD SPIKE
PNS	✖	POINT NOT SET

SCALE: 1" = 60'
0 30 60 120 180

© 2012 This drawing shall not be reproduced in whole or in part without written permission.

Revisions

06-13-2012: Revised to show marsh grass alignment and add dimensions.

East Coast Engineering & Surveying, P.C.
ENGINEERS-PLANNERS-SURVEYORS
Phone: 910.754.8029
Fax: 910.754.8046
Post Office Box 2467
Shallotte, North Carolina 28459
Firm License Number C-3014

PROPOSED FEEDER CANAL PIER ALIGNMENT SURVEY FOR:

SAMMY VARNAM

NORTH SHORE DRIVE EAST
SUNSET BEACH, NORTH CAROLINA

Date: 06-13-2012
Scale: 1"=60'
Drawn By: CDS
Checked By:

TOWNSHIP: SHALLOTTE
COUNTY: BRUNSWICK
STATE: NC
CREW: KS, JA, CS
FB/PG: 27-52

ECES PROJECT NO. 12-1163